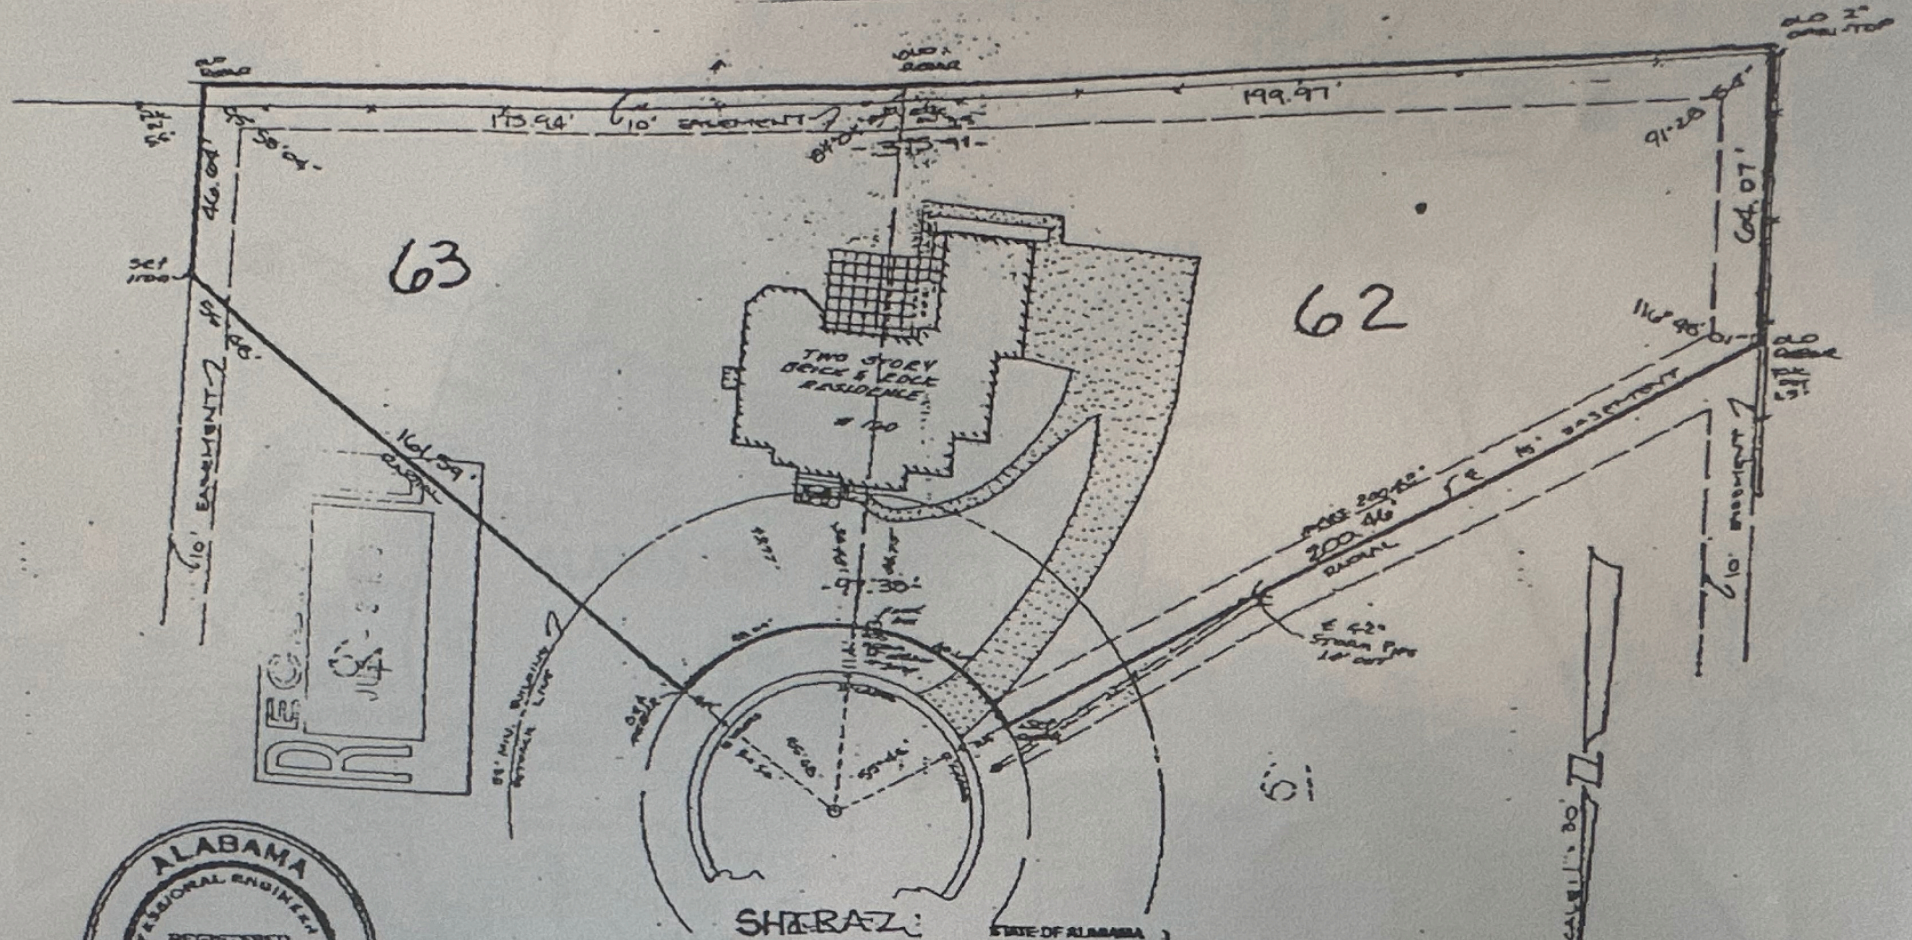

STATE OF ALABAMA
SHELBY COUNTY

AS-BUILT SURVEY

I, Laurence D. Weygand, a registered Engineer-Land Surveyor, certify that I have surveyed Lot 62-63, Block -, PHASE III WYNLAKE SUBDIVISION as recorded in Map Volume 21 Page 84 in the office of the Judge of Probate SHELBY County, Alabama; that there are no visible encroachments, overlapping or conflicting lines or structures except as shown; that there are no visible or apparent roadways or easements except as shown; that I have consulted the Federal Insurance Administration "Flood Hazard Boundary Map" and found that this property is not located in a "special flood hazard area"; that there are no wetlands as set forth in the Corps of Engineers Manual for Delineating Wetlands; that the minimum building setback lines are as shown; that improvements located on this survey meet the minimum technical standards for surveys as required by the State of Alabama (Code of Ala. 1975, Title 34, Chapter 11, Article 2); that this survey is made at address 160 SHIRAZ STREET, according to my survey of MAY 21, 1997.

RIGNEY -

Survey Field Book Page -

Flood Zone - C -

Order No. 17033

Community Panel No. 010191 0100B

Laurence D. Weygand, Reg. P.E. & L.S.
109 Chester Road, Birmingham, AL 35210
PH: 942-0088 FAX: 942-0087